
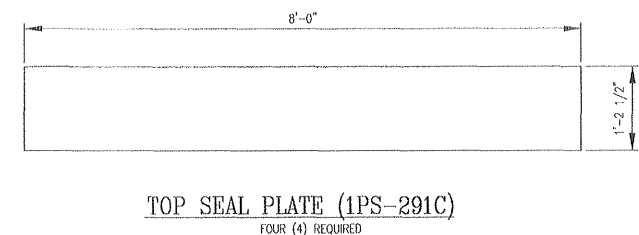
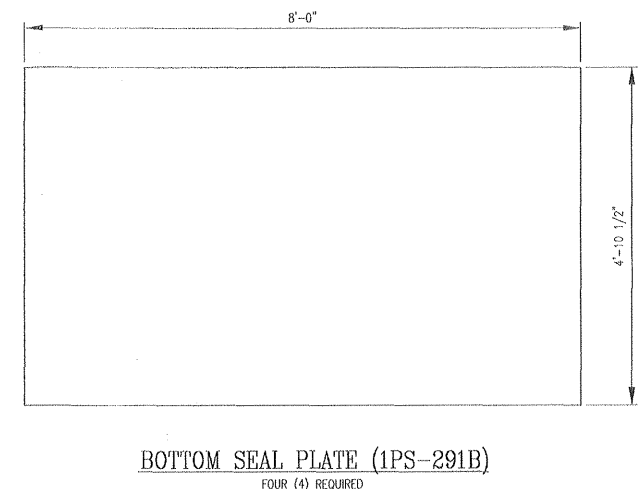


BILL OF MATERIAL			
ITEM	QTY	PART NO	DESCRIPTION
1	16	70291D-D2000302	SIDE SEAL PLATE (1PS-291A)
2	4	70291D-D2000302	BOTTOM SEAL PLATE (1PS-291B)
3	4	70291D-D2000302	TOP SEAL PLATE (1PS-291C)

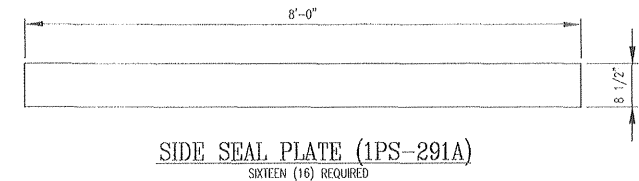

Review does not relieve contractor from responsibility for errors or deviations from contract requirements

UTILITY ENGINEERING

MRM

☒ NO EXCEPTIONS NOTED
Release for manufacture

☐ EXCEPTIONS NOTED
Release for manufacture

☐ RETURNED FOR CORRECTION
Do not proceed

☐ Revise and resubmit for authorization

NOTES:

- FIELD WELD, BETWEEN EACH BAY AND CATALYST SUPPORT, TO BE CONTINUOUS ALONG ENTIRE INTERIOR JOINT.
- DAFFLE KEEPER TO BE INSTALLED BY FIELD ERECTOR.

Nooter/Eriksen Inc.
VENDOR SUBMITTAL REVIEW

REVIEW OF VENDOR DRAWINGS DOES NOT RELIEVE THE VENDOR OF RESPONSIBILITIES FOR ACCURACY OF DIMENSIONS AND COMPLIANCE TO CODES, MODULAR ERIKSEN SPECIFICATIONS AND P.O. REQUIREMENTS

☒ A REVIEWED AND ACCEPTED (WORK MAY PROCEED)

☐ B REVIEWED WITH COMMENTS (WORK MAY PROCEED)

☐ C REVISE AND RESUBMIT (WORK MAY NOT PROCEED)

☐ D REVIEWED FOR INFORMATION ONLY

RELEASE DATE: 7-29-02 REVIEWERS INITIALS: UR RF

PROJECT: JEA BRANDY JOB NO CODE SHT REV FE

DRAWING NO. 014139-SC-306 A X

M010322-541A002 RA
JEA BRANDY BRANCH
8/12/2002

PEERLESS MFG. CO.
2819 WALNUT HILL LANE
DALLAS, TEXAS 75229
(214) 357-6181

CUST: NOOTER/ERIKSEN, INC.
PROJ: JEA BRANDY
LOCATION: BALDWIN, FL

SCALE: N.T.S. DATE: 01/17/02 P.O. NO: 17457

TITLE: INTERNAL STRUCTURE SEAL PLATE PROCEDURE

DRN BY: FM CHK'D: P.E.: REV. 2

SO NO DOC NO 70291D D2000903