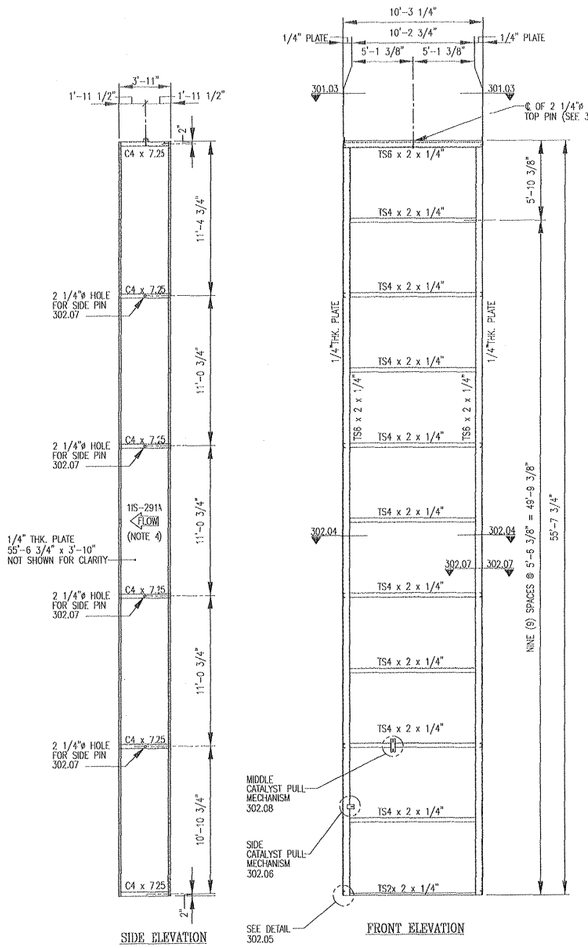

SIDE BAY

ONE (1) AS SHOWN W/MARK 1IS-291A
ONE (1) OPPOSITE HAND W/MARK 1IS-291C

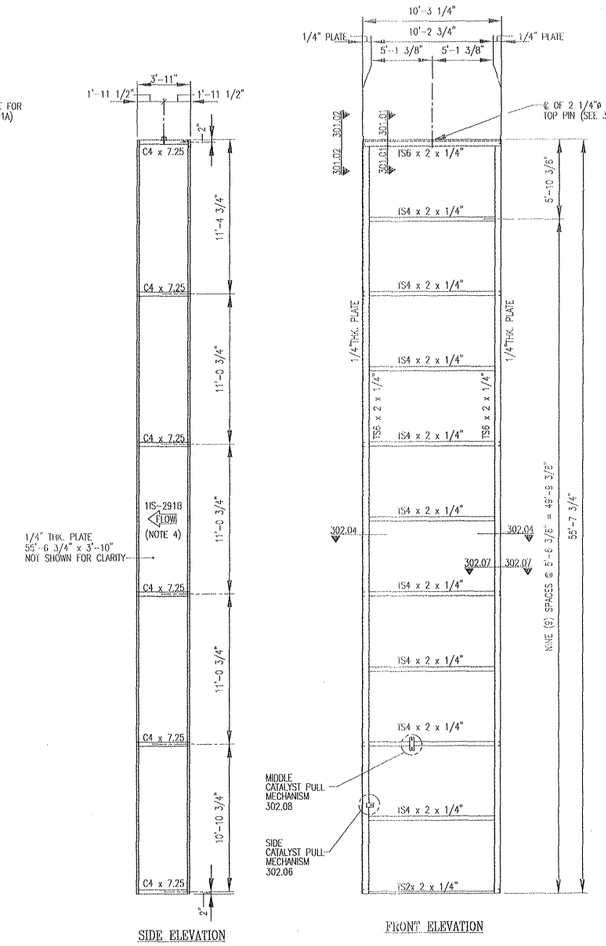

MIDDLE BAY

ONE (1) AS SHOWN W/MARK 1IS-291B

Review does not relieve contractor from responsibility for errors or deviations from contract requirements

UTILITY ENGINEERING

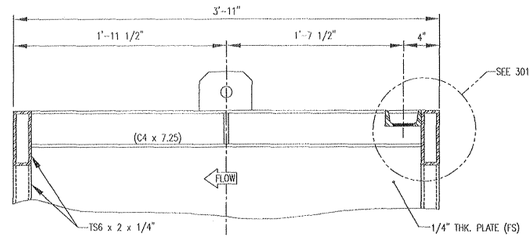

301/01 SECTION @ C4 x 7.25 & TS6 x 2
SCALE: 1 1/2" = 1'-0"

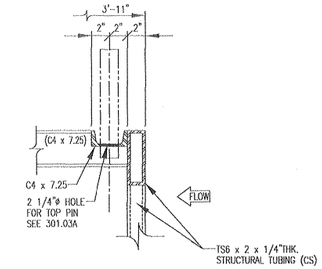

301/01A TOP PIN CONNECTION
SCALE: 1 1/2" = 1'-0" (x8)
(TYP 3 PLC'S)

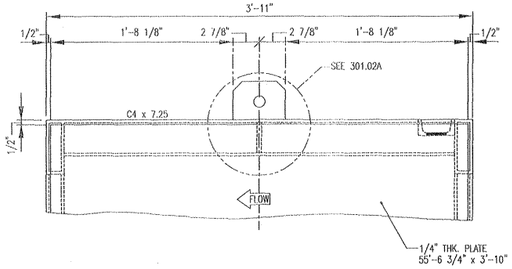

301/02 SECTION @ 1/4" THK. PLATE
SCALE: 1 1/2" = 1'-0"

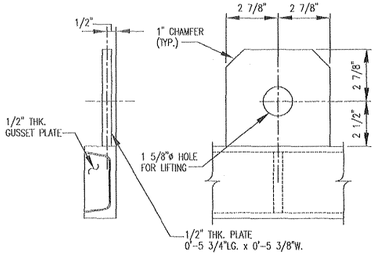

301/02A INTERNAL STRUCTURE LIFTING LUG
(TYP. 6 PLC'S.)
SCALE: 3" = 1'-0"
NOTE 7

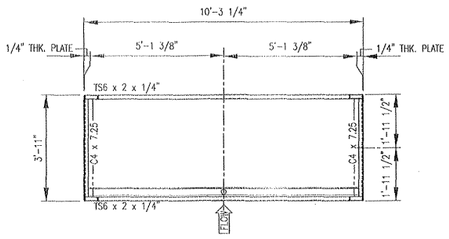

301/03 TOP VIEW OF BAY
SCALE: 3/8" = 1'-0"

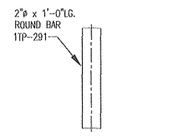

301/03A TOP PIN
SCALE: 1 1/2" = 1'-0"
(TYP. 3 PLC'S.)

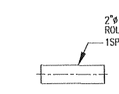

301/03B SIDE PIN
SCALE: 1 1/2" = 1'-0"
(TYP. 8 PLC'S.)

- [X] NO EXCEPTIONS NOTED
  Release for manufacture
- [ ] EXCEPTIONS NOTED
  Release for manufacture
  Revise and resubmit for distribution
- [ ] RETURNED FOR CORRECTION
  Do not proceed
  Revise and resubmit for authorization

M010322-541A003 RA

JEA BRANDY BRANCH **8/5/2002**

NOTES:

1. STRUCTURAL TO BE FABRICATED PER AWS D1.1.
2. MTR'S REQUIRED ON STRUCTURAL STEEL.
3. UNLESS NOTED OTHERWISE, ALL CONNECTIONS SHALL BE 1/4" FILLET WELDS.
4. FLOW DIRECTION & PART # TO BE STENCILED ON STRUCTURE AS SHOWN.
5. TWO (2) UNITS ARE REQUIRED. UNIT #1 IS SHOWN.
   TAGGING SYSTEM:
   UNIT #1 HAS THE PREFIX 1
   UNIT #2 HAS THE PREFIX 2
6. CONTINUOUS WELD 1/4" PLATE ON TOP SIDE, UPSTREAM SIDE, DOWNSTREAM SIDE & BOTTOM SIDE.
7. LIFTING LUGS TO BE PAINTED YELLOW AND REMOVED BY FIELD ERECTORS AFTER INSTALLATION.

NOOTER/ERIKSEN INC.
VENDOR SUBMITTAL REVIEW

REVIEW OF VENDOR DRAWINGS DOES NOT RELIEVE THE VENDOR OF RESPONSIBILITIES FOR ACCURACY OF DIMENSIONS AND COMPLIANCE TO CODES, NOOTER ERIKSEN SPECIFICATIONS AND P.O. REQUIREMENTS

[X]	A	REVIEWED AND ACCEPTED
[ ]	B	REVIEWED WITH COMMENTS (WORK MAY PROCEED)
[ ]	C	REVISE AND RESUBMIT (WORK MAY NOT PROCEED)
[ ]	D	REVIEWED FOR INFORMATION ONLY

RELEASE DATE: 7-29-02 REVIEWERS INITIALS JK RF

PROJECT: JEA BRANDY	JOB NO CODE SHT	REV	FE
DRAWING NO.	014139-SC-307	A	X

REV	DESCRIPTION	CK	BY	DATE
0	A. INITIAL ISSUE.		FM	05/30/02

CONFIDENTIAL

THIS DRAWING IS THE SOLE PROPERTY OF PEERLESS MFG. COMPANY AND SHALL NOT BE REPRODUCED, COPIED, LOANED ALTERED, NOR USED FOR ANY PURPOSE OTHER THAN FOR WHICH IT IS FURNISHED EXCEPT WITH THE WRITTEN PERMISSION OF PEERLESS MFG. COMPANY.

PEERLESS MFG CO DALLAS TEXAS

Rev 2 8/15/06

PEERLESS MFG. CO.

2819 WALNUT HILL LANE
DALLAS, TEXAS 75229
(214) 357-6181

CUST: NOOTER/ERIKSEN, INC.
PROJ: JEA BRANDY
LOCATION: BALDWIN, FL
SCALE: 3/16"=1'-0" | DATE: 05/30/02 | P.O. NO: 17457

TITLE: INTERNAL STRUCTURE FABRICATION DETAIL | QTY. 2

DRN BY: FM | CHK'D: | P.E.: | REV.

SO NO — DOC NO: 70291D — D2000301 | 0